



APPENDIX B, FIGURE 1

**Magnetic Field Measurement Taken
Monday, November 28, 2005 at 1:55 pm
Temperature: 49°F
Measuring Crew:
Jim Knapwurst
Mike Sinclair**

1	11-8-05		ADD NOTES				
REV	DATE	W.O.#	DESCRIPTION	DRAWN	CHK'D	APPRO	CMT

SCALE


NTS



THIS DOCUMENT IS FOR THE USE OF AMERICAN TRANSMISSION COMPANY. AMERICAN TRANSMISSION COMPANY DISCLAIMS ALL WARRANTIES, BOTH EXPRESS AND IMPLIED, USE BY ANYONE OTHER THAN

**HUIKAMP SUBSTATION EMF READING
GENERAL DRAWING**

ENGINEERING RECORD DRAWING NUMBER ER - 10 - 000059 - 025


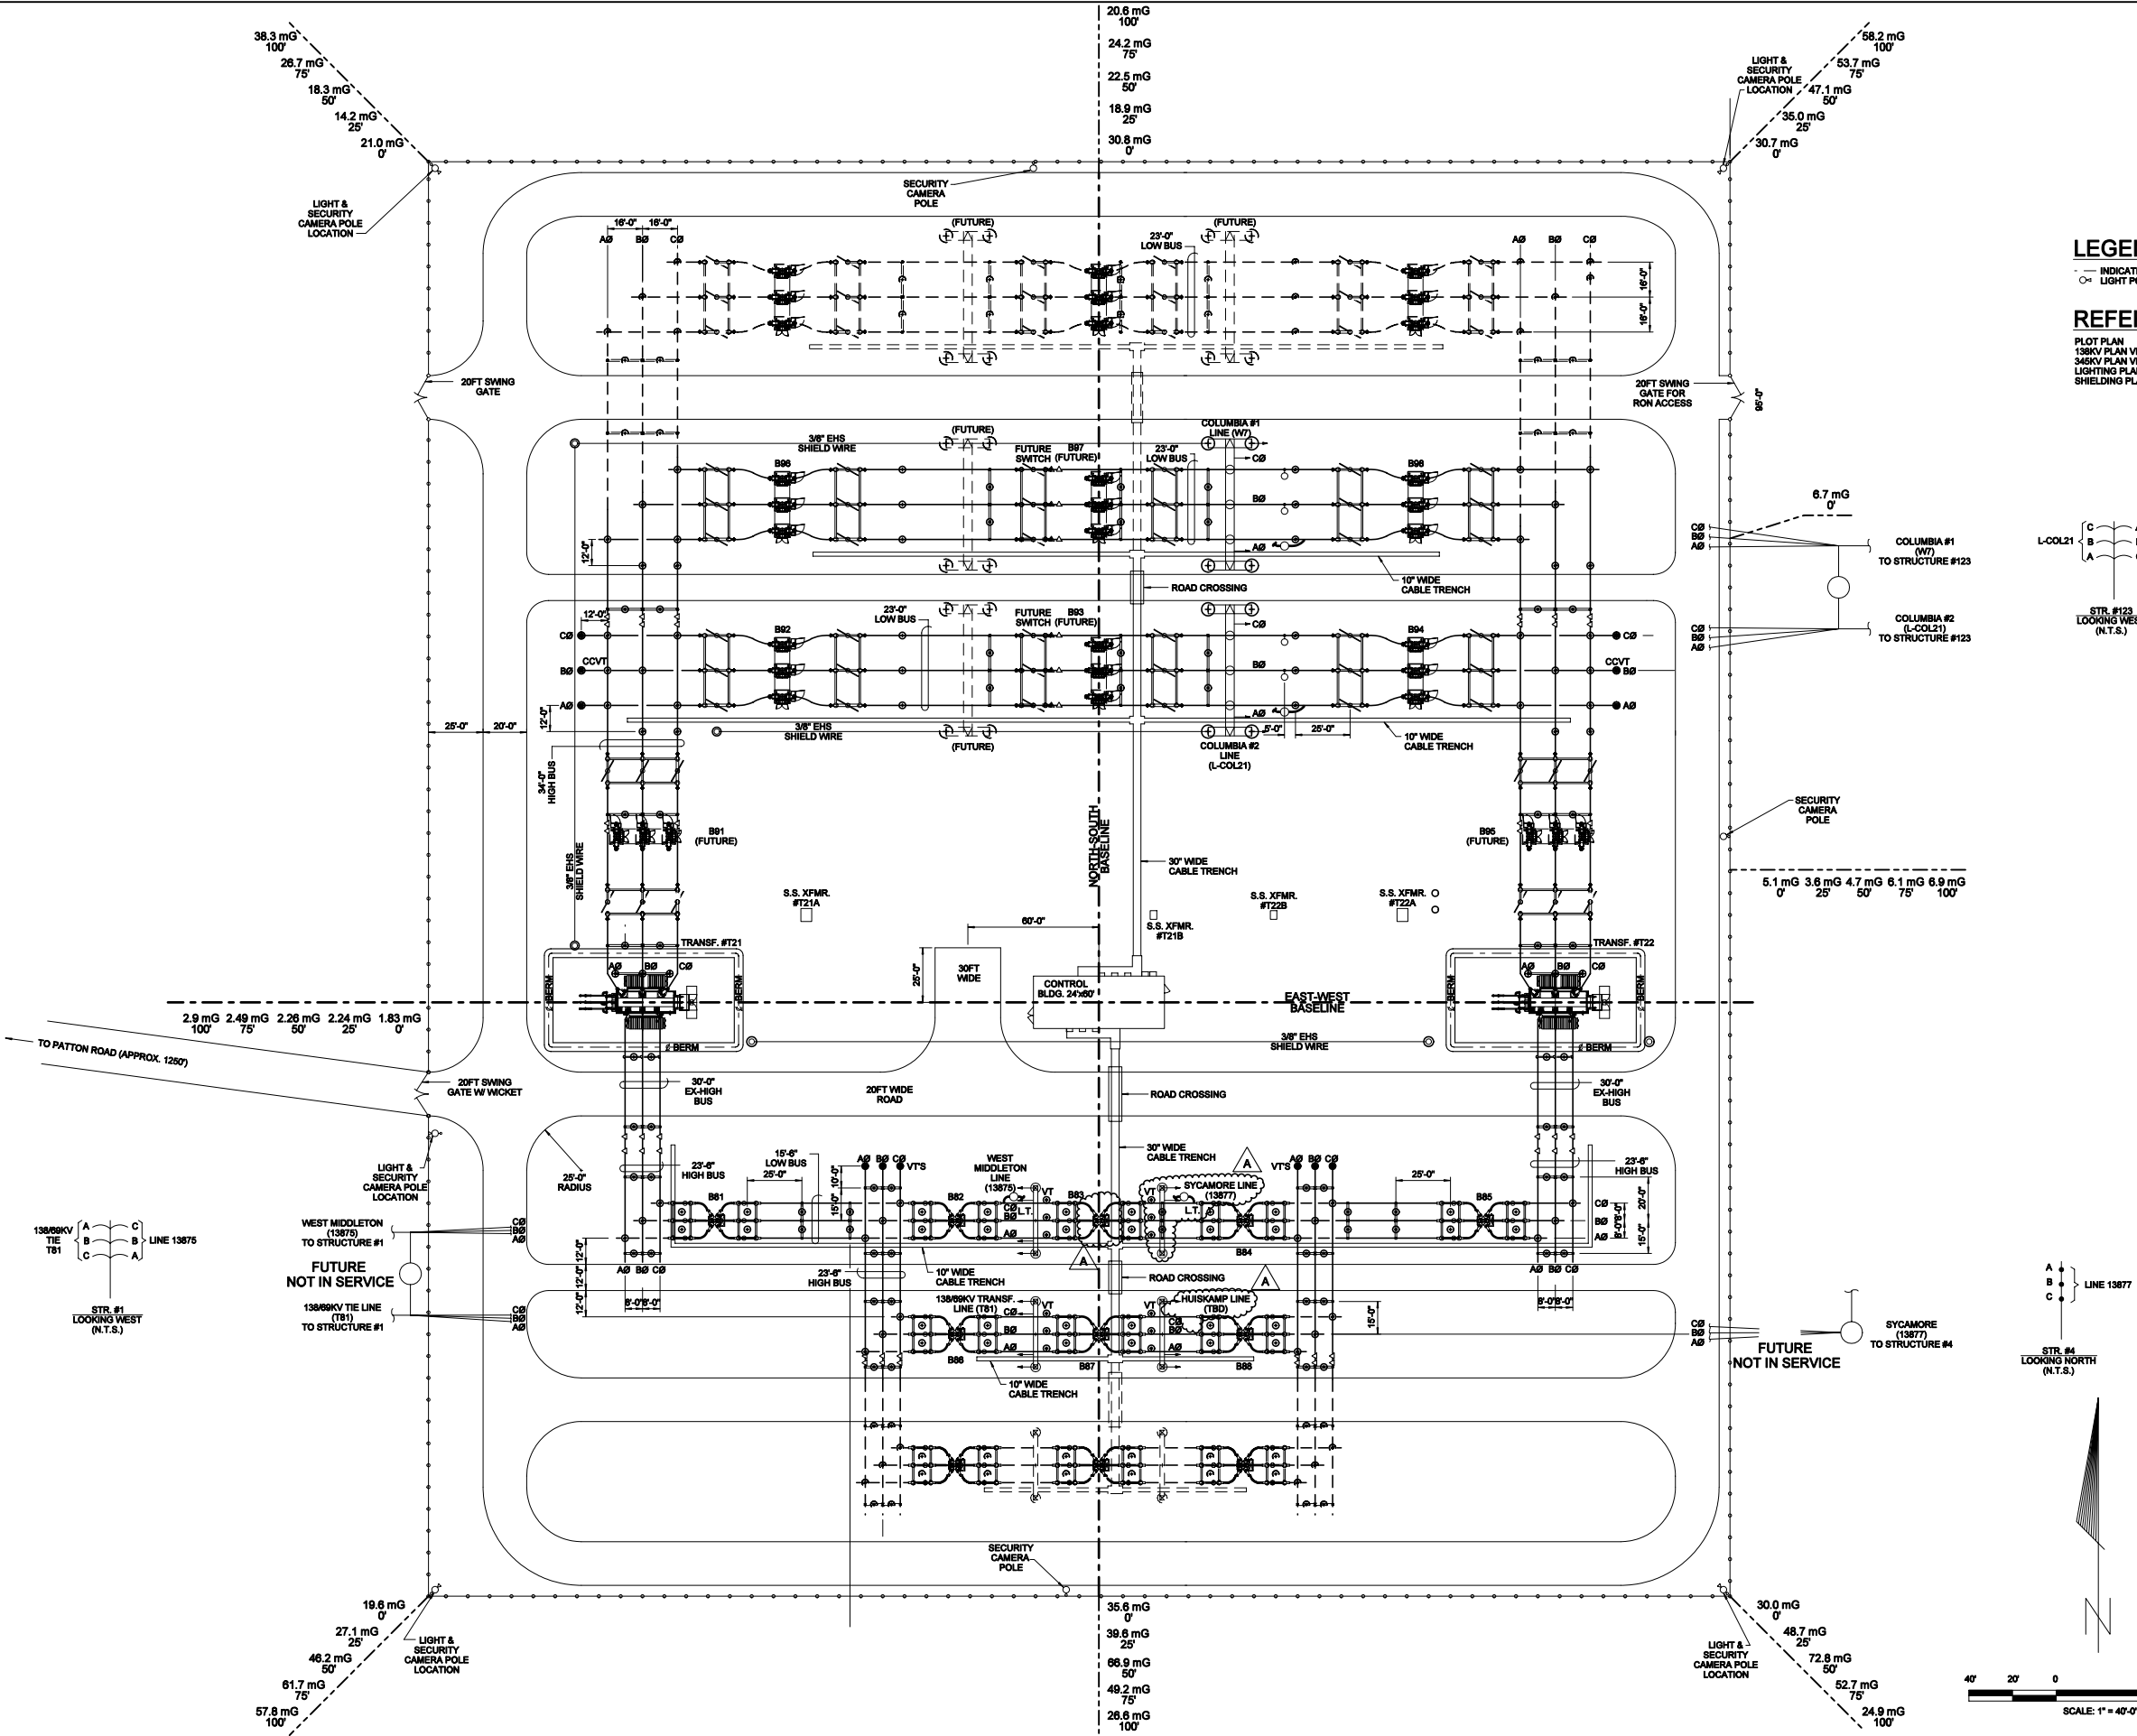


LEGEND

- INDICATES FUTURE
- LIGHT POLE & FIXTURE

REFERENCE DRAWINGS

- | | |
|-----------------|-------|
| PLOT PLAN | 02-04 |
| 138KV PLAN VIEW | 05-10 |
| 345KV PLAN VIEW | 05-30 |
| LIGHTING PLAN | 05-40 |
| SHIELDING PLAN | 05-50 |

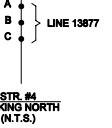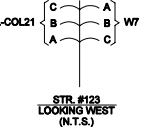


APPENDIX B, FIGURE 2



REV	DATE	W.O. #	ADD NOTES	DESCRIPTION	DRAWN	CHKD	APPD	CMFY
1	11-8-05							



APPENDIX B, FIGURE 3

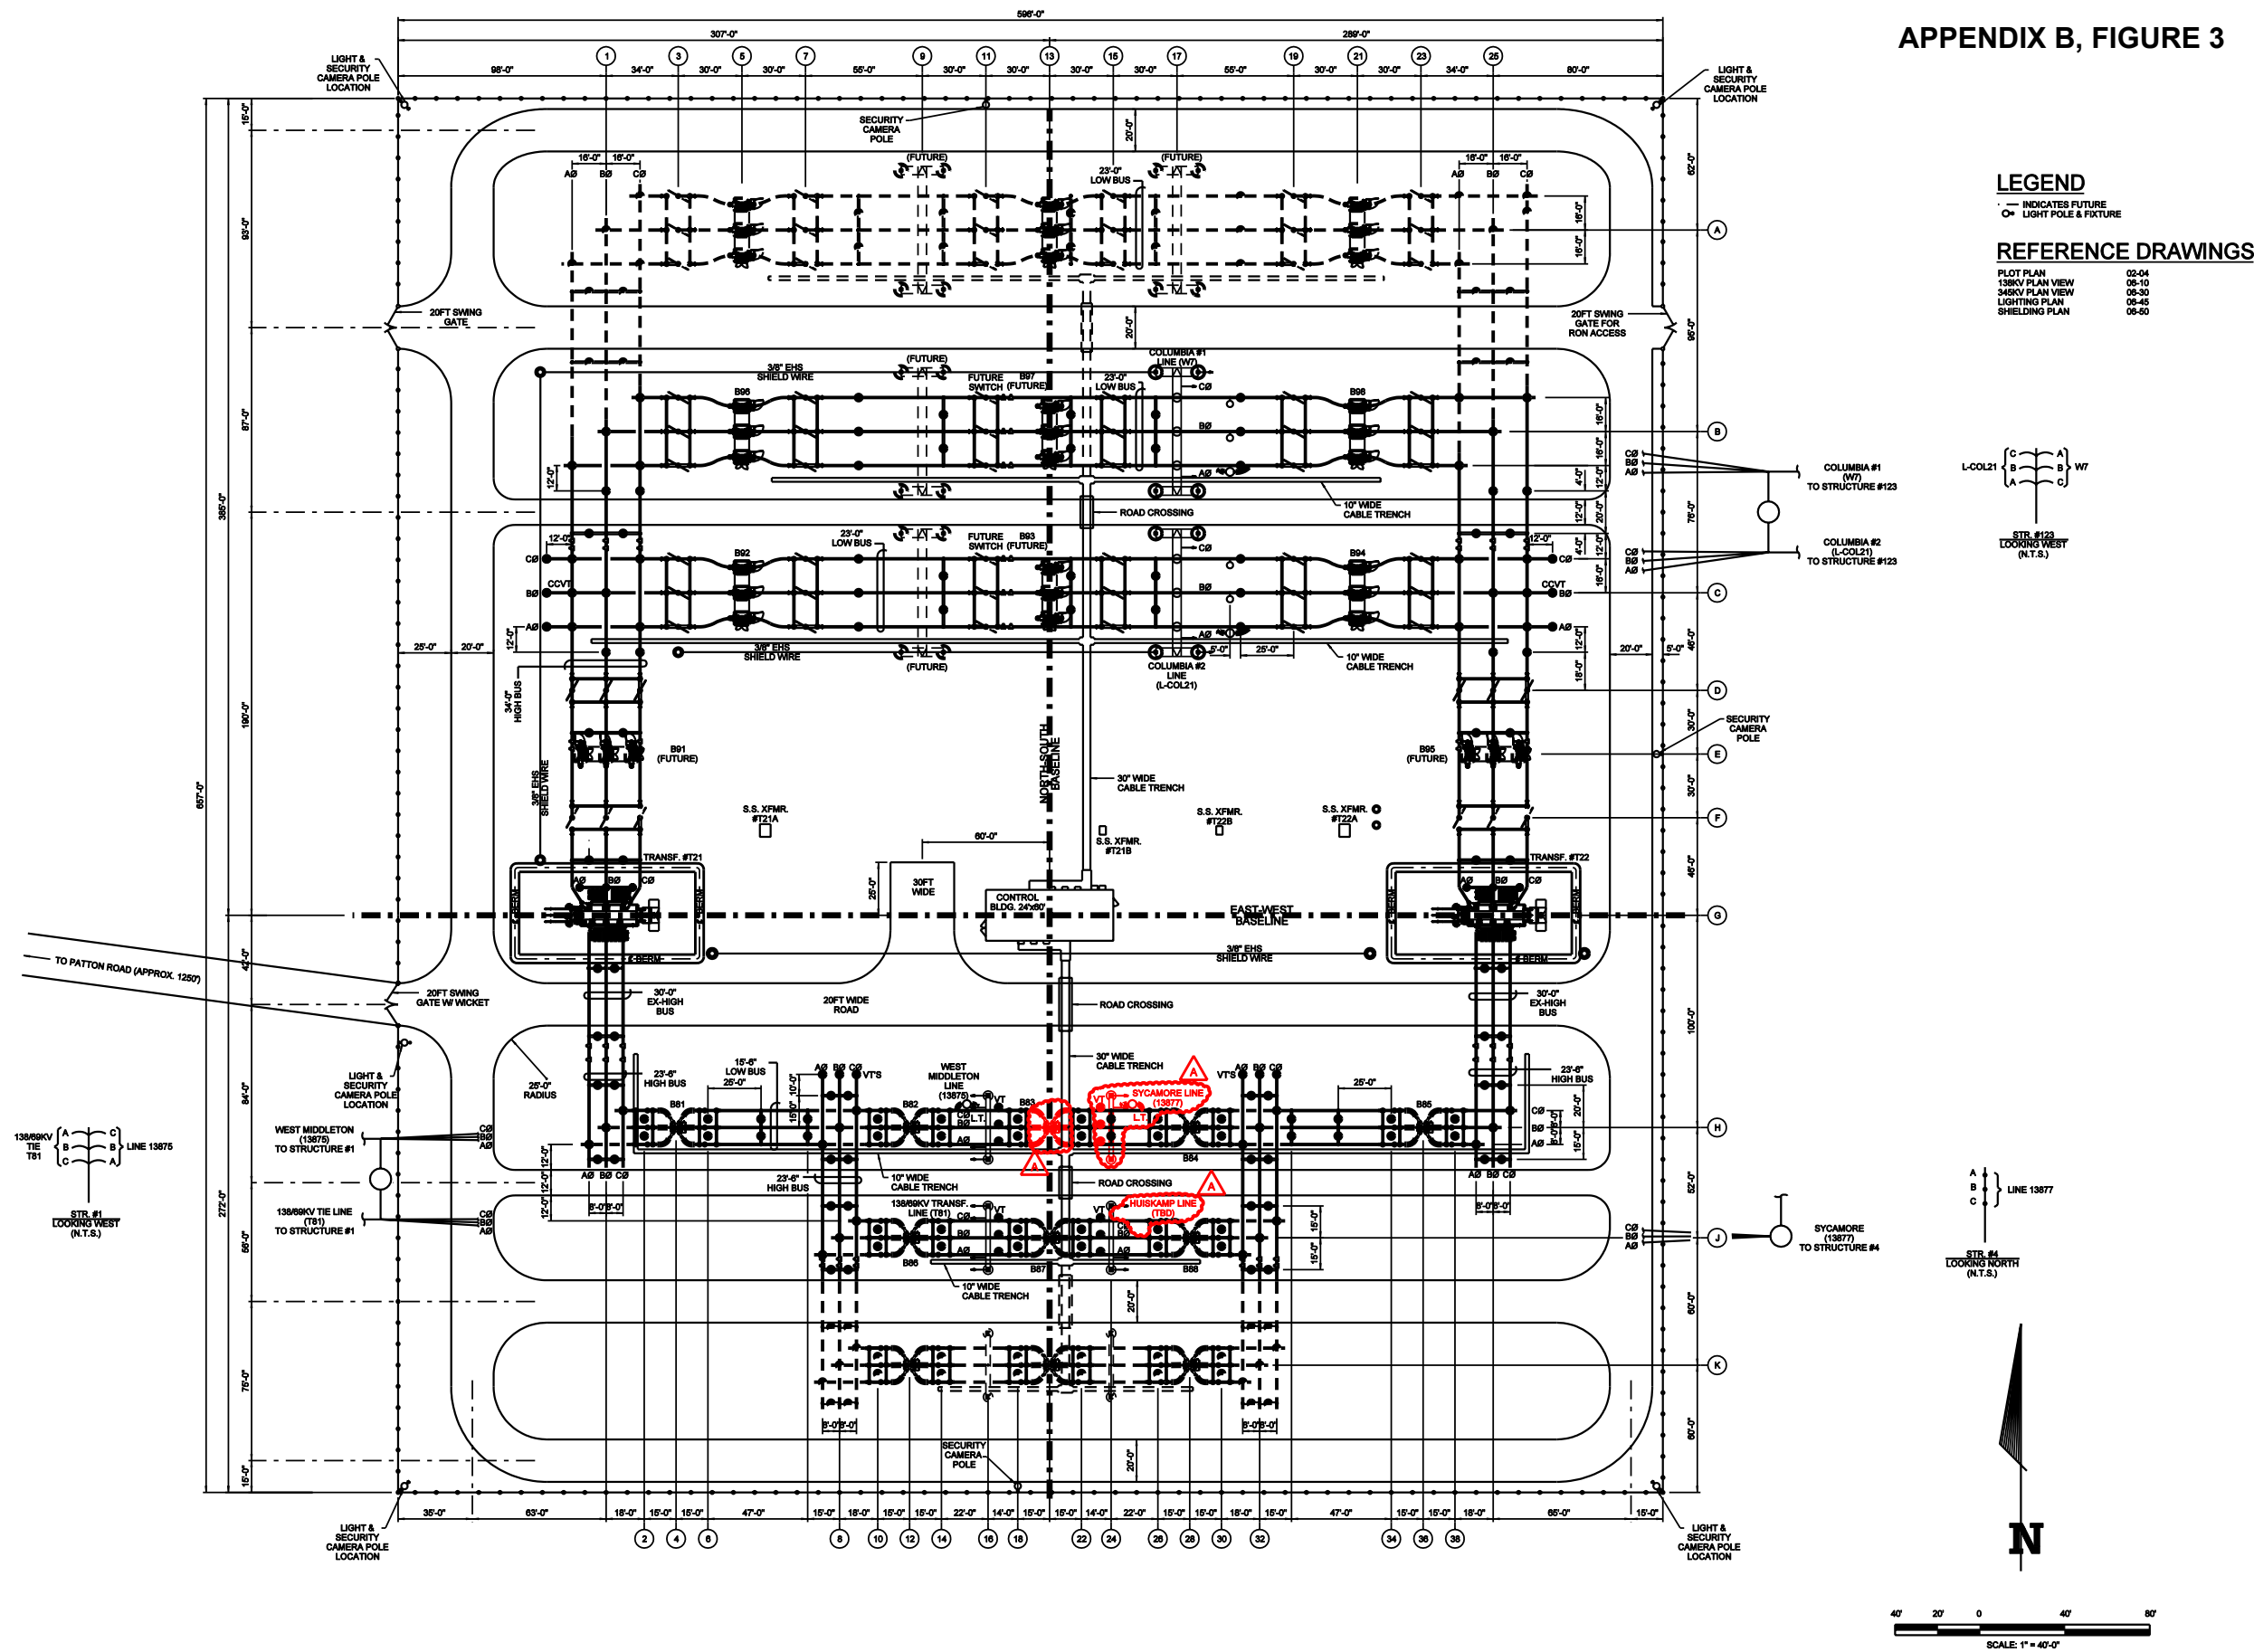

A				ISSUED FOR REVIEW				DAK				ECL			
0				ISSUED FOR CONSTRUCTION				PEI				PEI			
REV				DATE				W.O.#				DESCRIPTION			
2/25/05				61908											

